

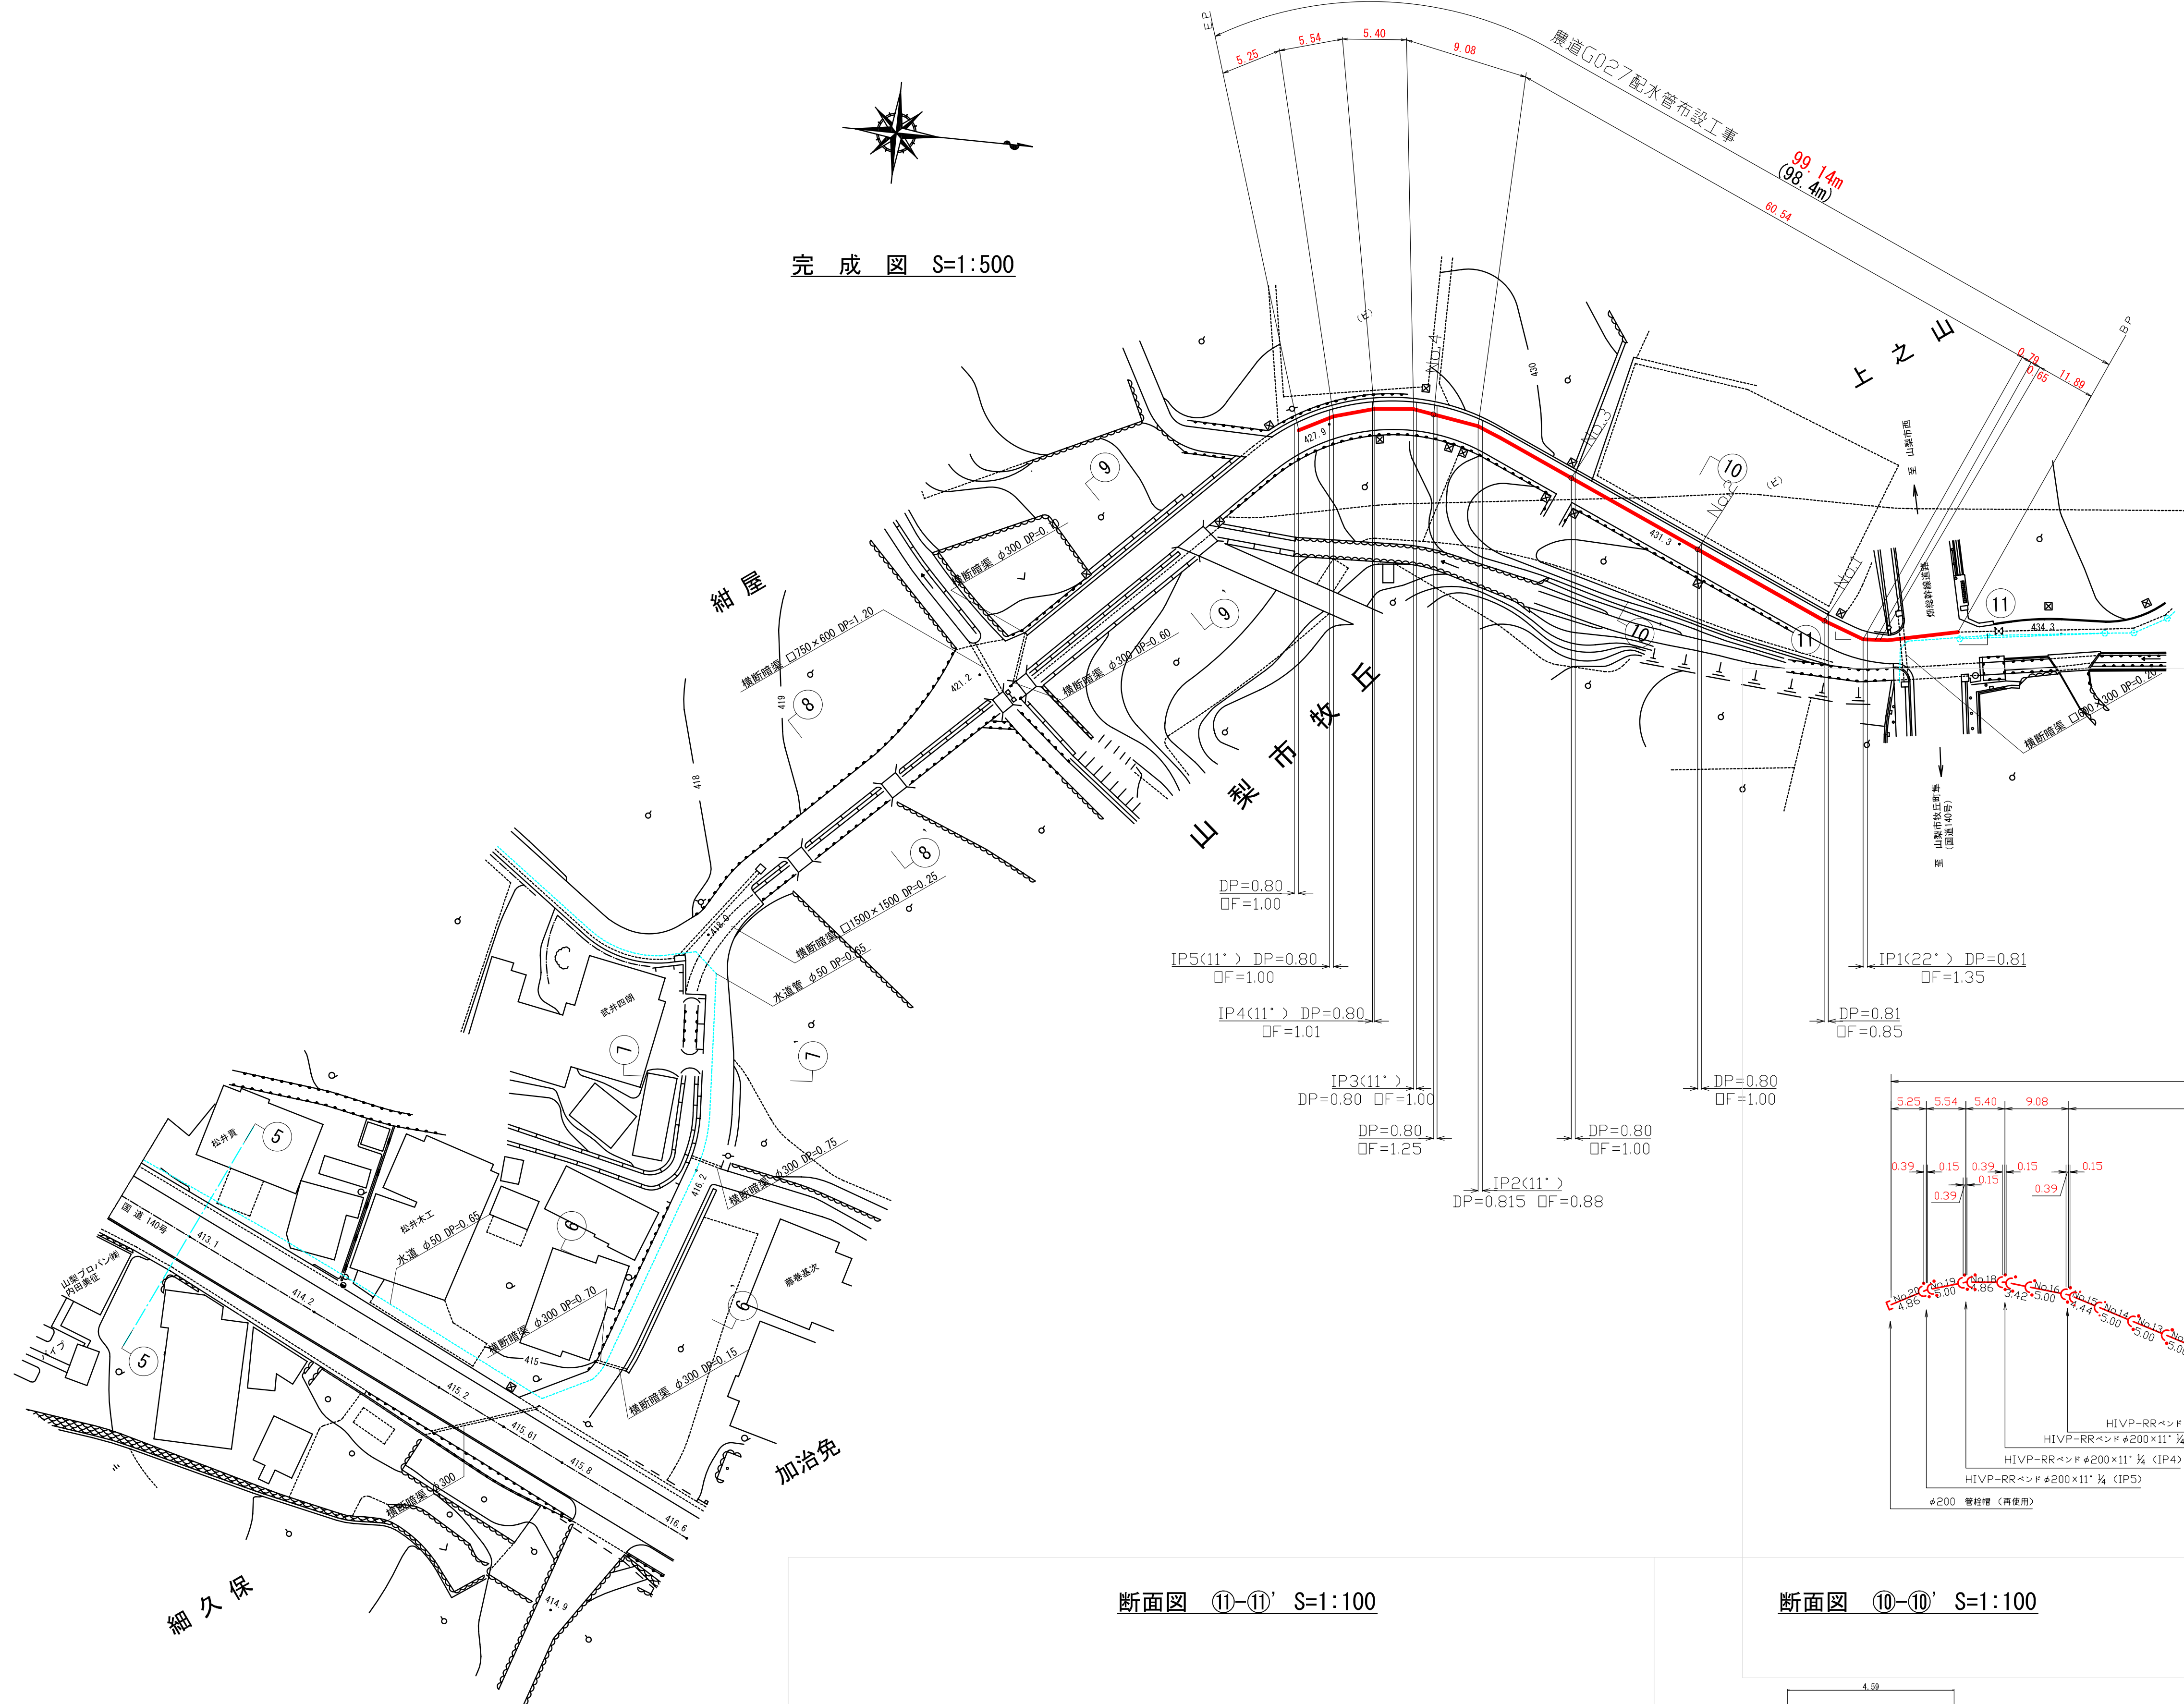


管種	設計	実測	差引	図中色
VP-RRφ200	98.40	99.14	+0.74	赤


完成図 S=1:500

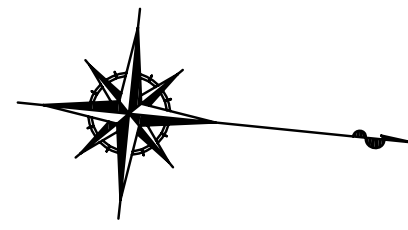

配管図 S=1:500

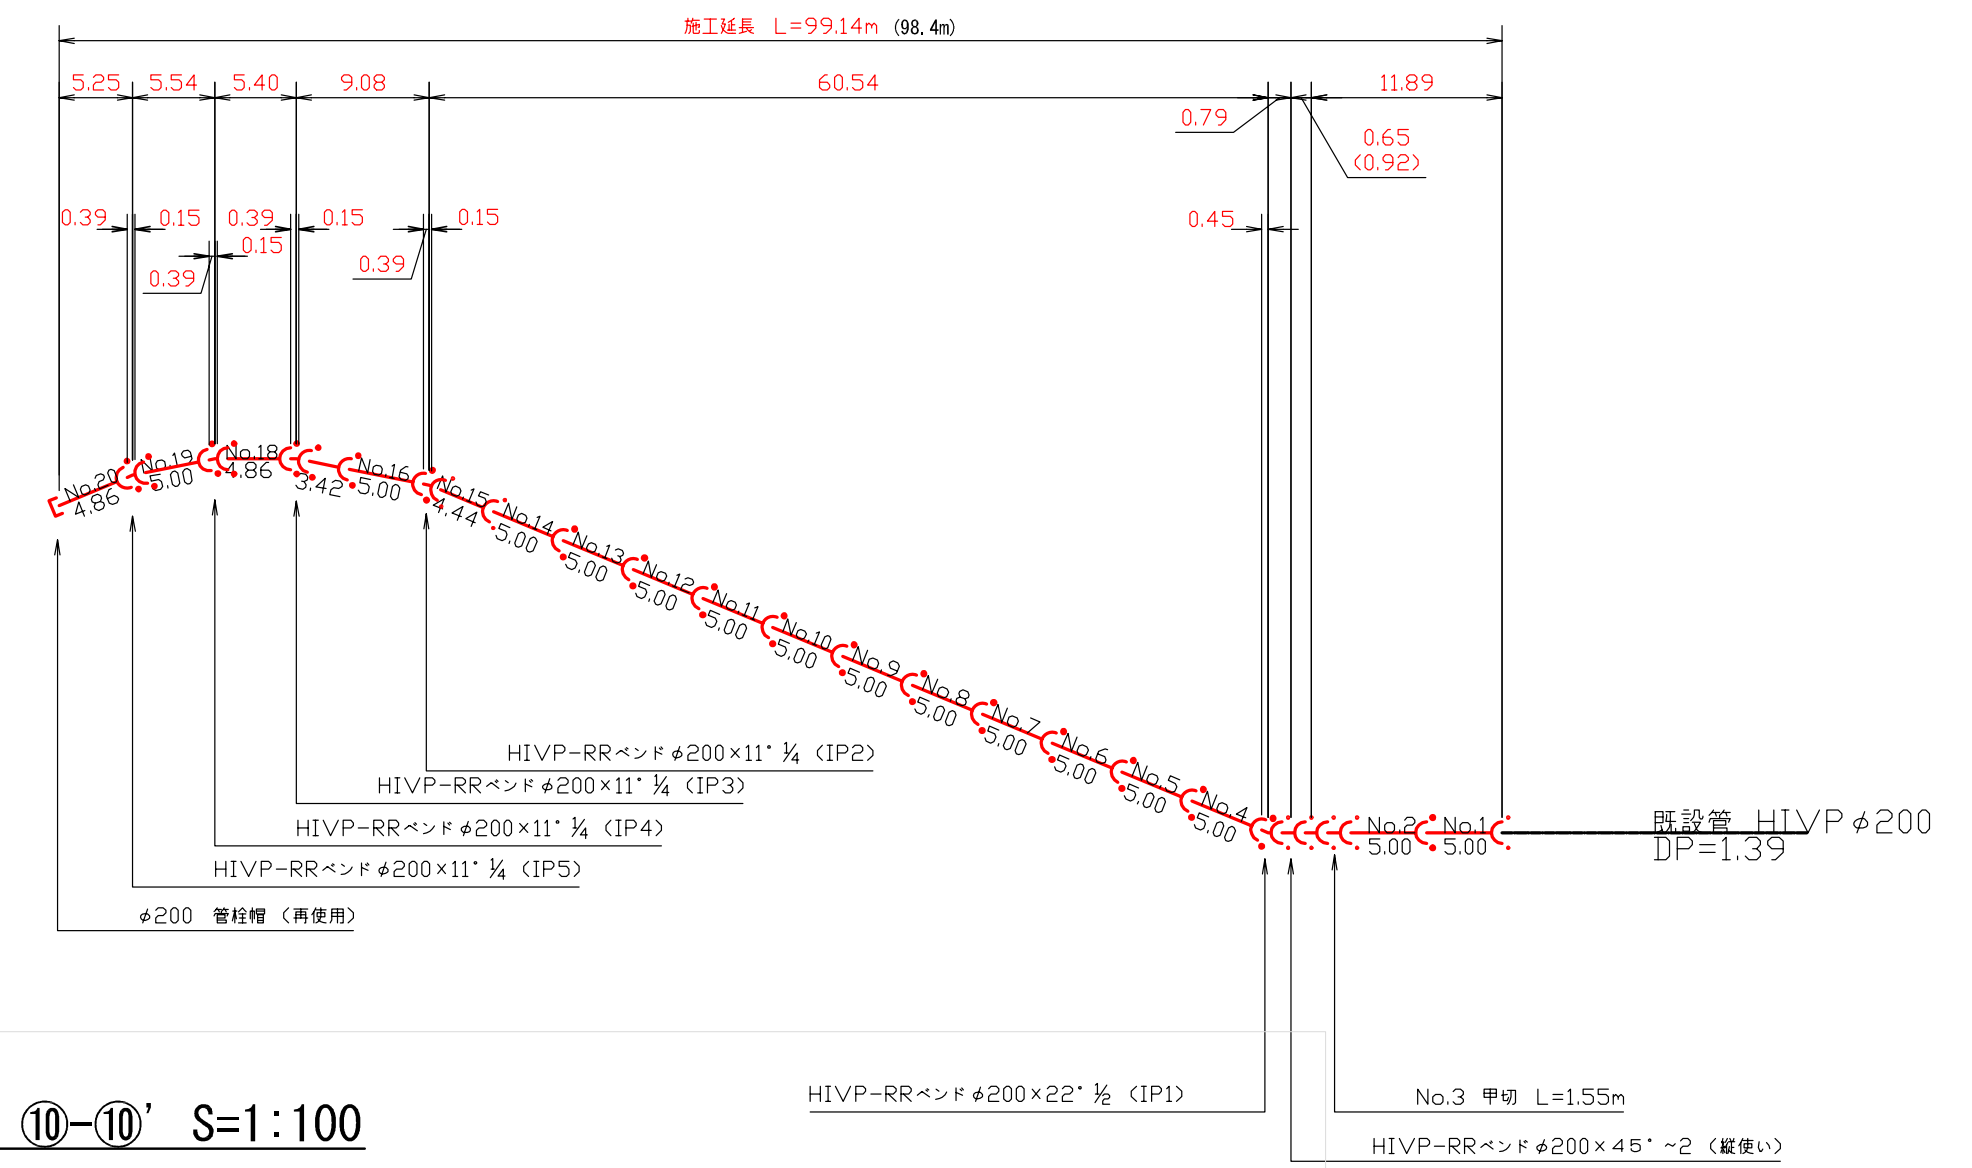

断面図 ⑩-⑩' S=1:100

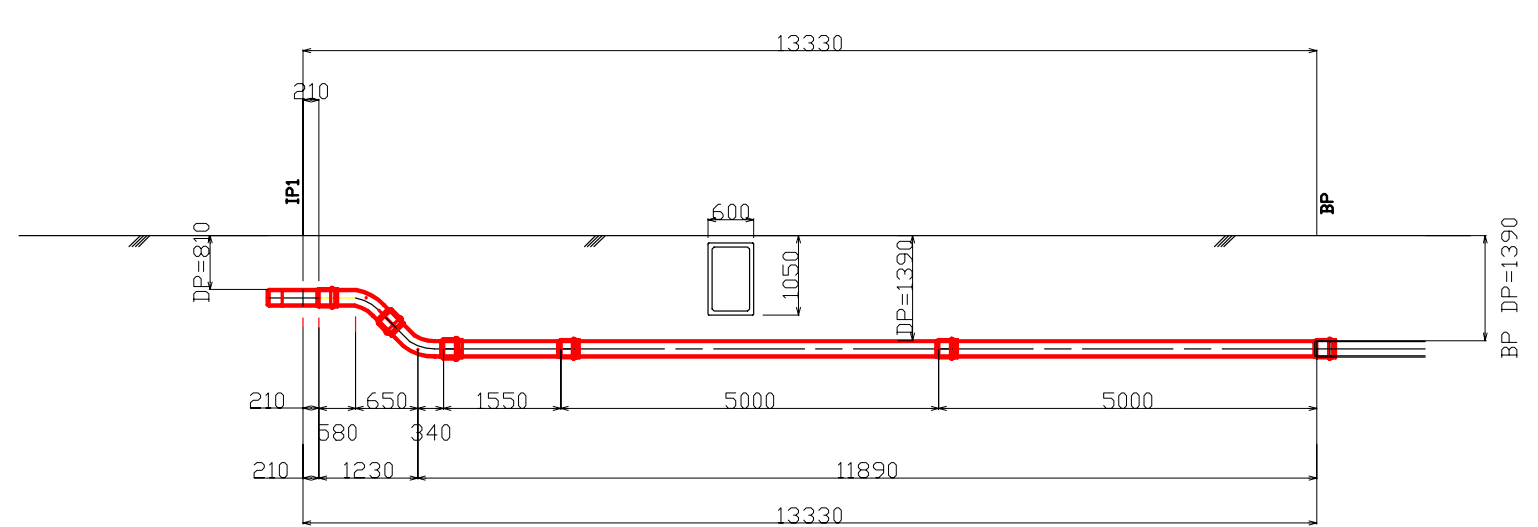

断面図 ⑪-⑪' S=1:100

